


LEGEND:

	REMOVE EXISTING PARTITION, DOOR & FRAME. PATCH REMAINING WALLS AS NEEDED.
	INSTALL NEW INSULATED PARTITION, DOOR & FRAME. FINISHES AS SPECIFIED BY DESIGNER.
	REMOVE EXISTING DUPLEX OUTLET
	INSTALL NEW DUPLEX, WALL MOUNTED OUTLET
	DEMO LIGHT SWITCH

- NOTES:**
1. CONTRACTOR TO VERIFY ALL EXISTING CONDITIONS.
 2. CONTRACTOR TO NOTIFY DESIGNER OF ANY DISCREPANCIES TO AS-BUILT CONDITIONS.
 3. CONSTRUCTION IS TO BE IN COMPLIANCE WITH ALL LOCAL AND FEDERAL BUILDING CODES.
 4. CONTRACTOR SHALL BE RESPONSIBLE FOR THE CLEAN UP AND DISPOSAL OF ALL TRASH AND DEBRIS IN COMPLIANCE WITH MANAGEMENT.
 5. WHERE APPLICABLE STRUCTURAL, MECHANICAL, ELECTRICAL, AND PLUMBING DRAWINGS ARE SUPPLEMENTAL TO THE ARCHITECTURAL DRAWINGS.
 6. ALL MATERIALS, AND FINISHES INDICATED ON PLANS SHALL BE NEW AND UNUSED, UNLESS OTHERWISE NOTED.
 7. PROVIDE NEW PAINT THROUGHOUT, TWO COATS, SMOOTH TEXTURE.
 8. NEW KITCHEN CABINETS DEWILS INDUSTRIES, SERIES CONTEMPORARY, STYLE TRIFID, WOOD CHERRY, COLOR 113.


PROJECT DATA:

GENERAL	
Project Name:	Chugach Electric Association, Inc.
Project Address:	5601 Electron Drive Anchorage, Alaska 99519
Owner:	Chugach Electric Association, Inc.
Tenant Name:	Chugach Electric
Legal Description:	International Industrial Cntr TR 2
BUILDING ANALYSIS	
Floors:	2
Project Location:	Floor 2
Construction:	Type I - A
Occupancy:	B
Alarmed:	Yes
Sprinkled:	Yes
Parking:	No Increase Required
Occupant Load:	1284 SF / 30 = 42.8 413 SF / 300 = 1.3

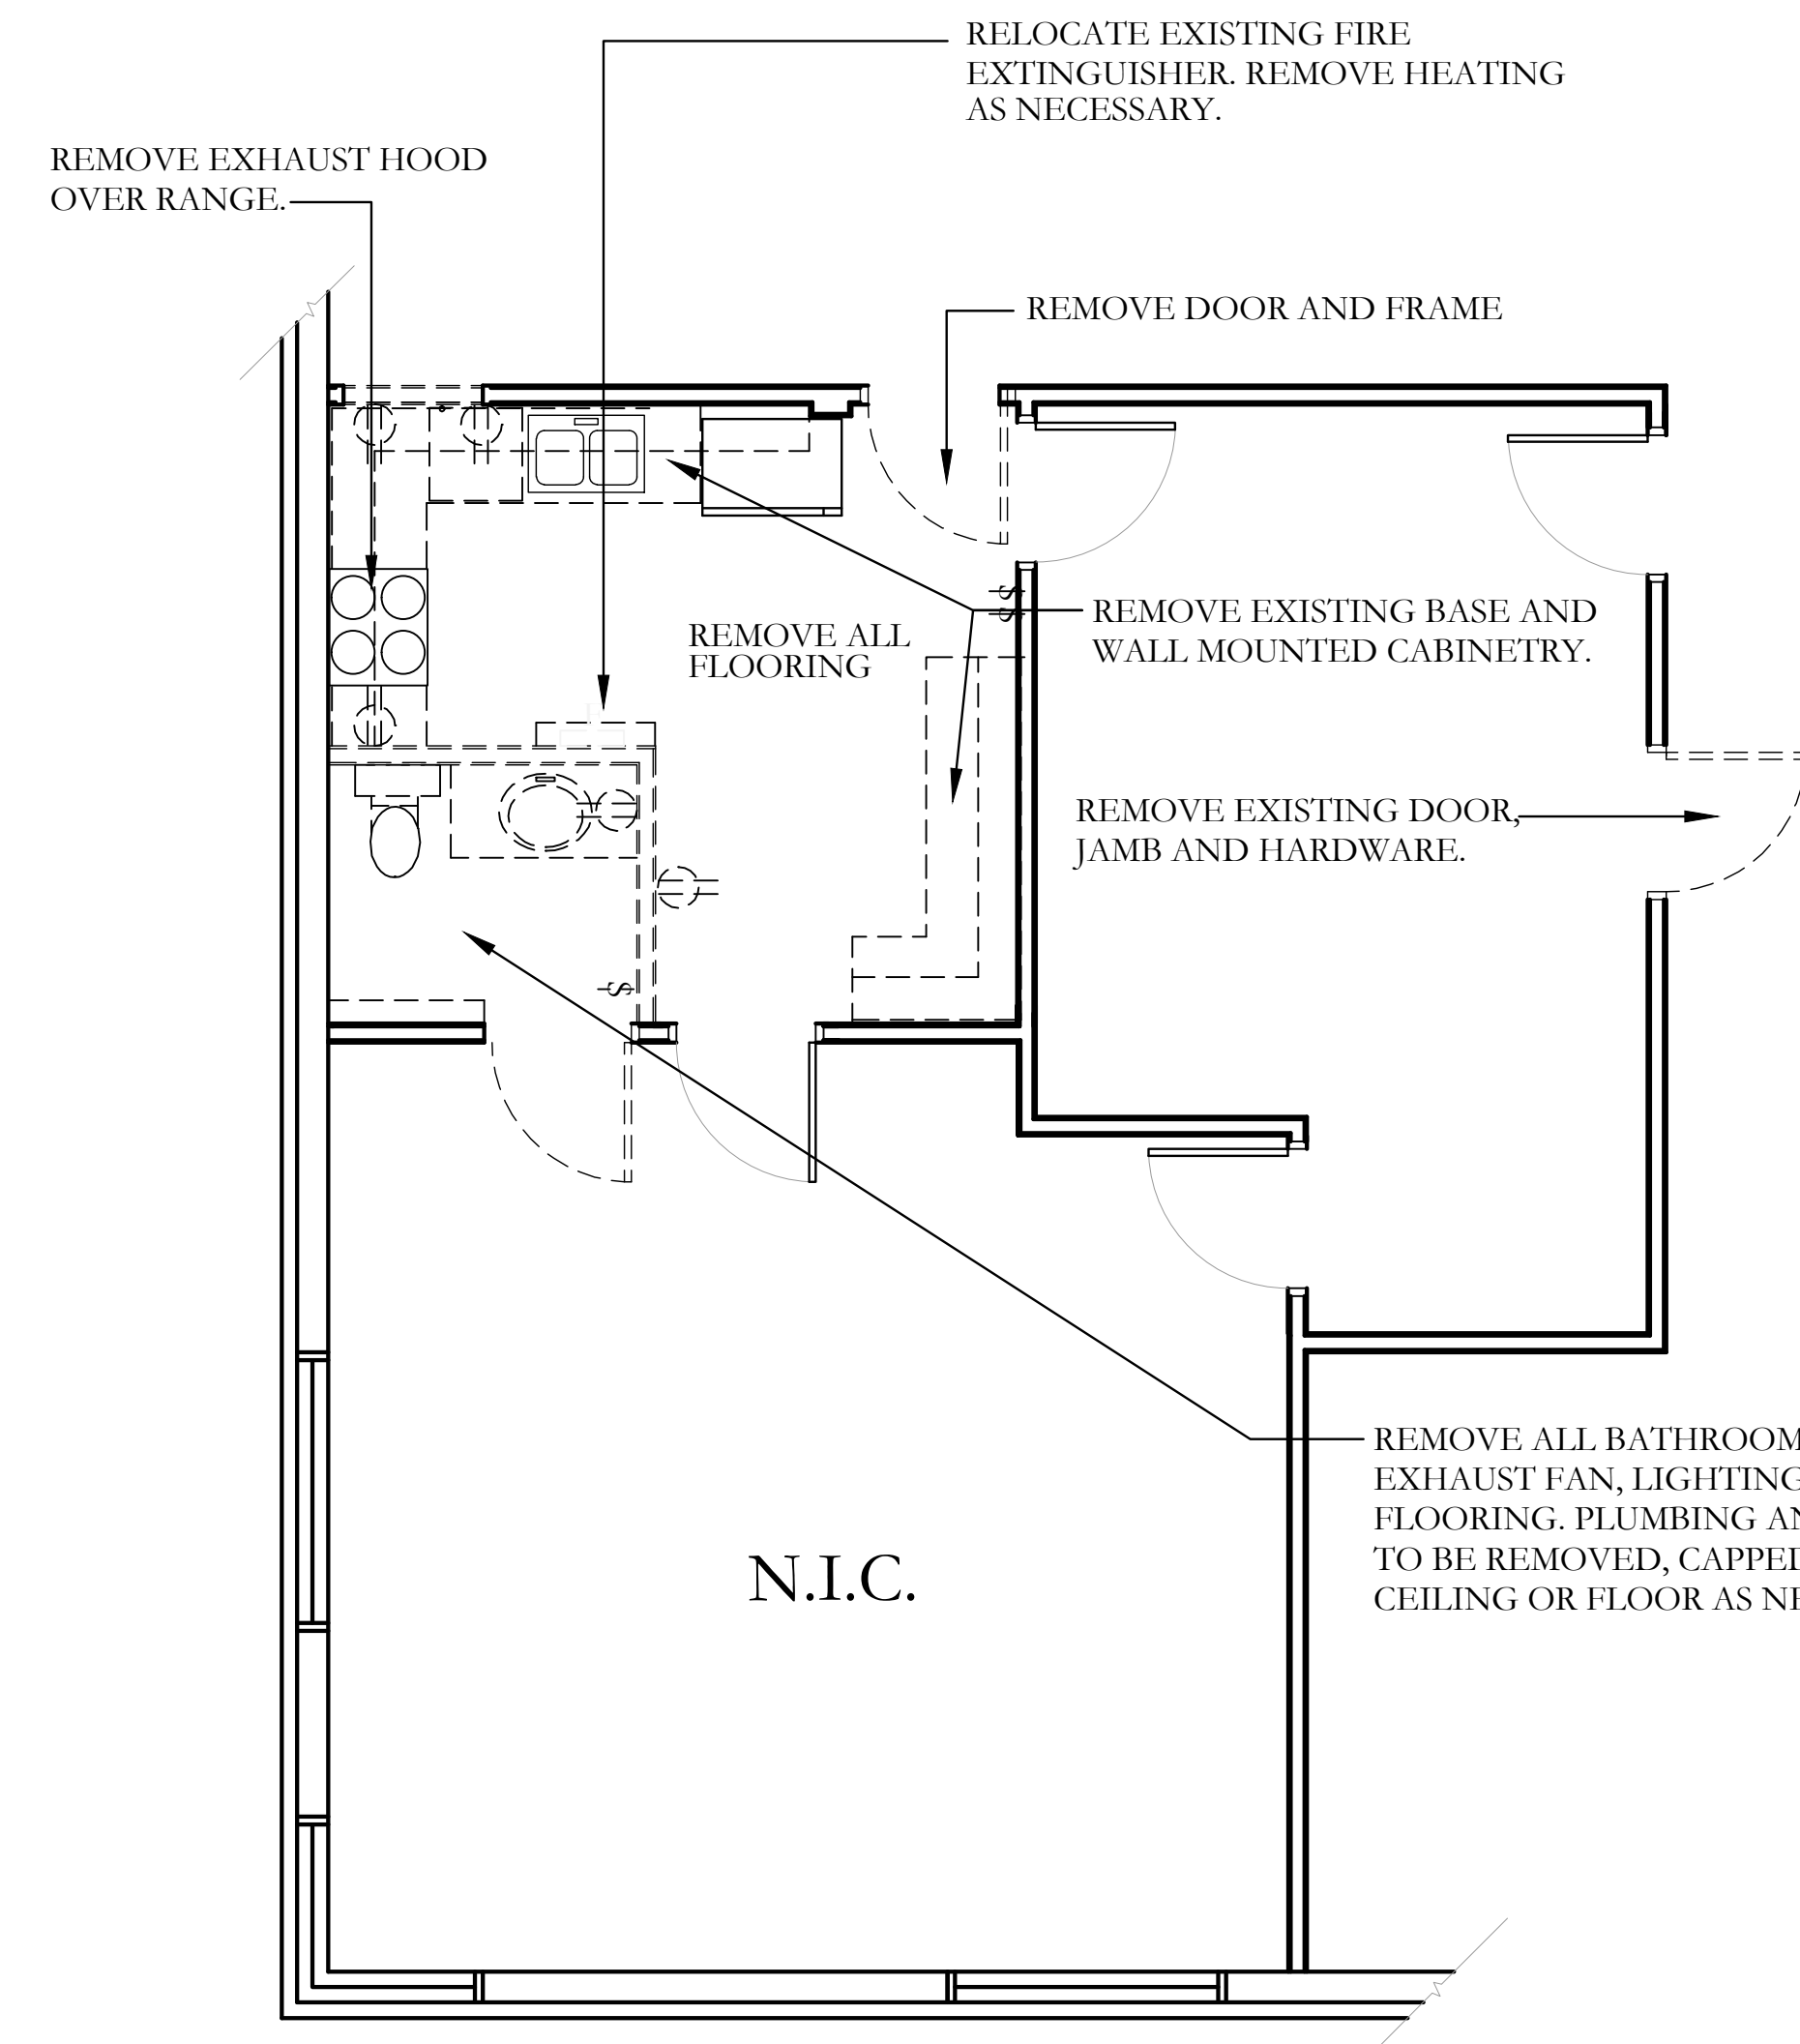


**EXECUTIVE KITCHEN REMODEL
PARTITION PLAN - DEMOLITION**

SCALE: 1/4" = 1'-0"

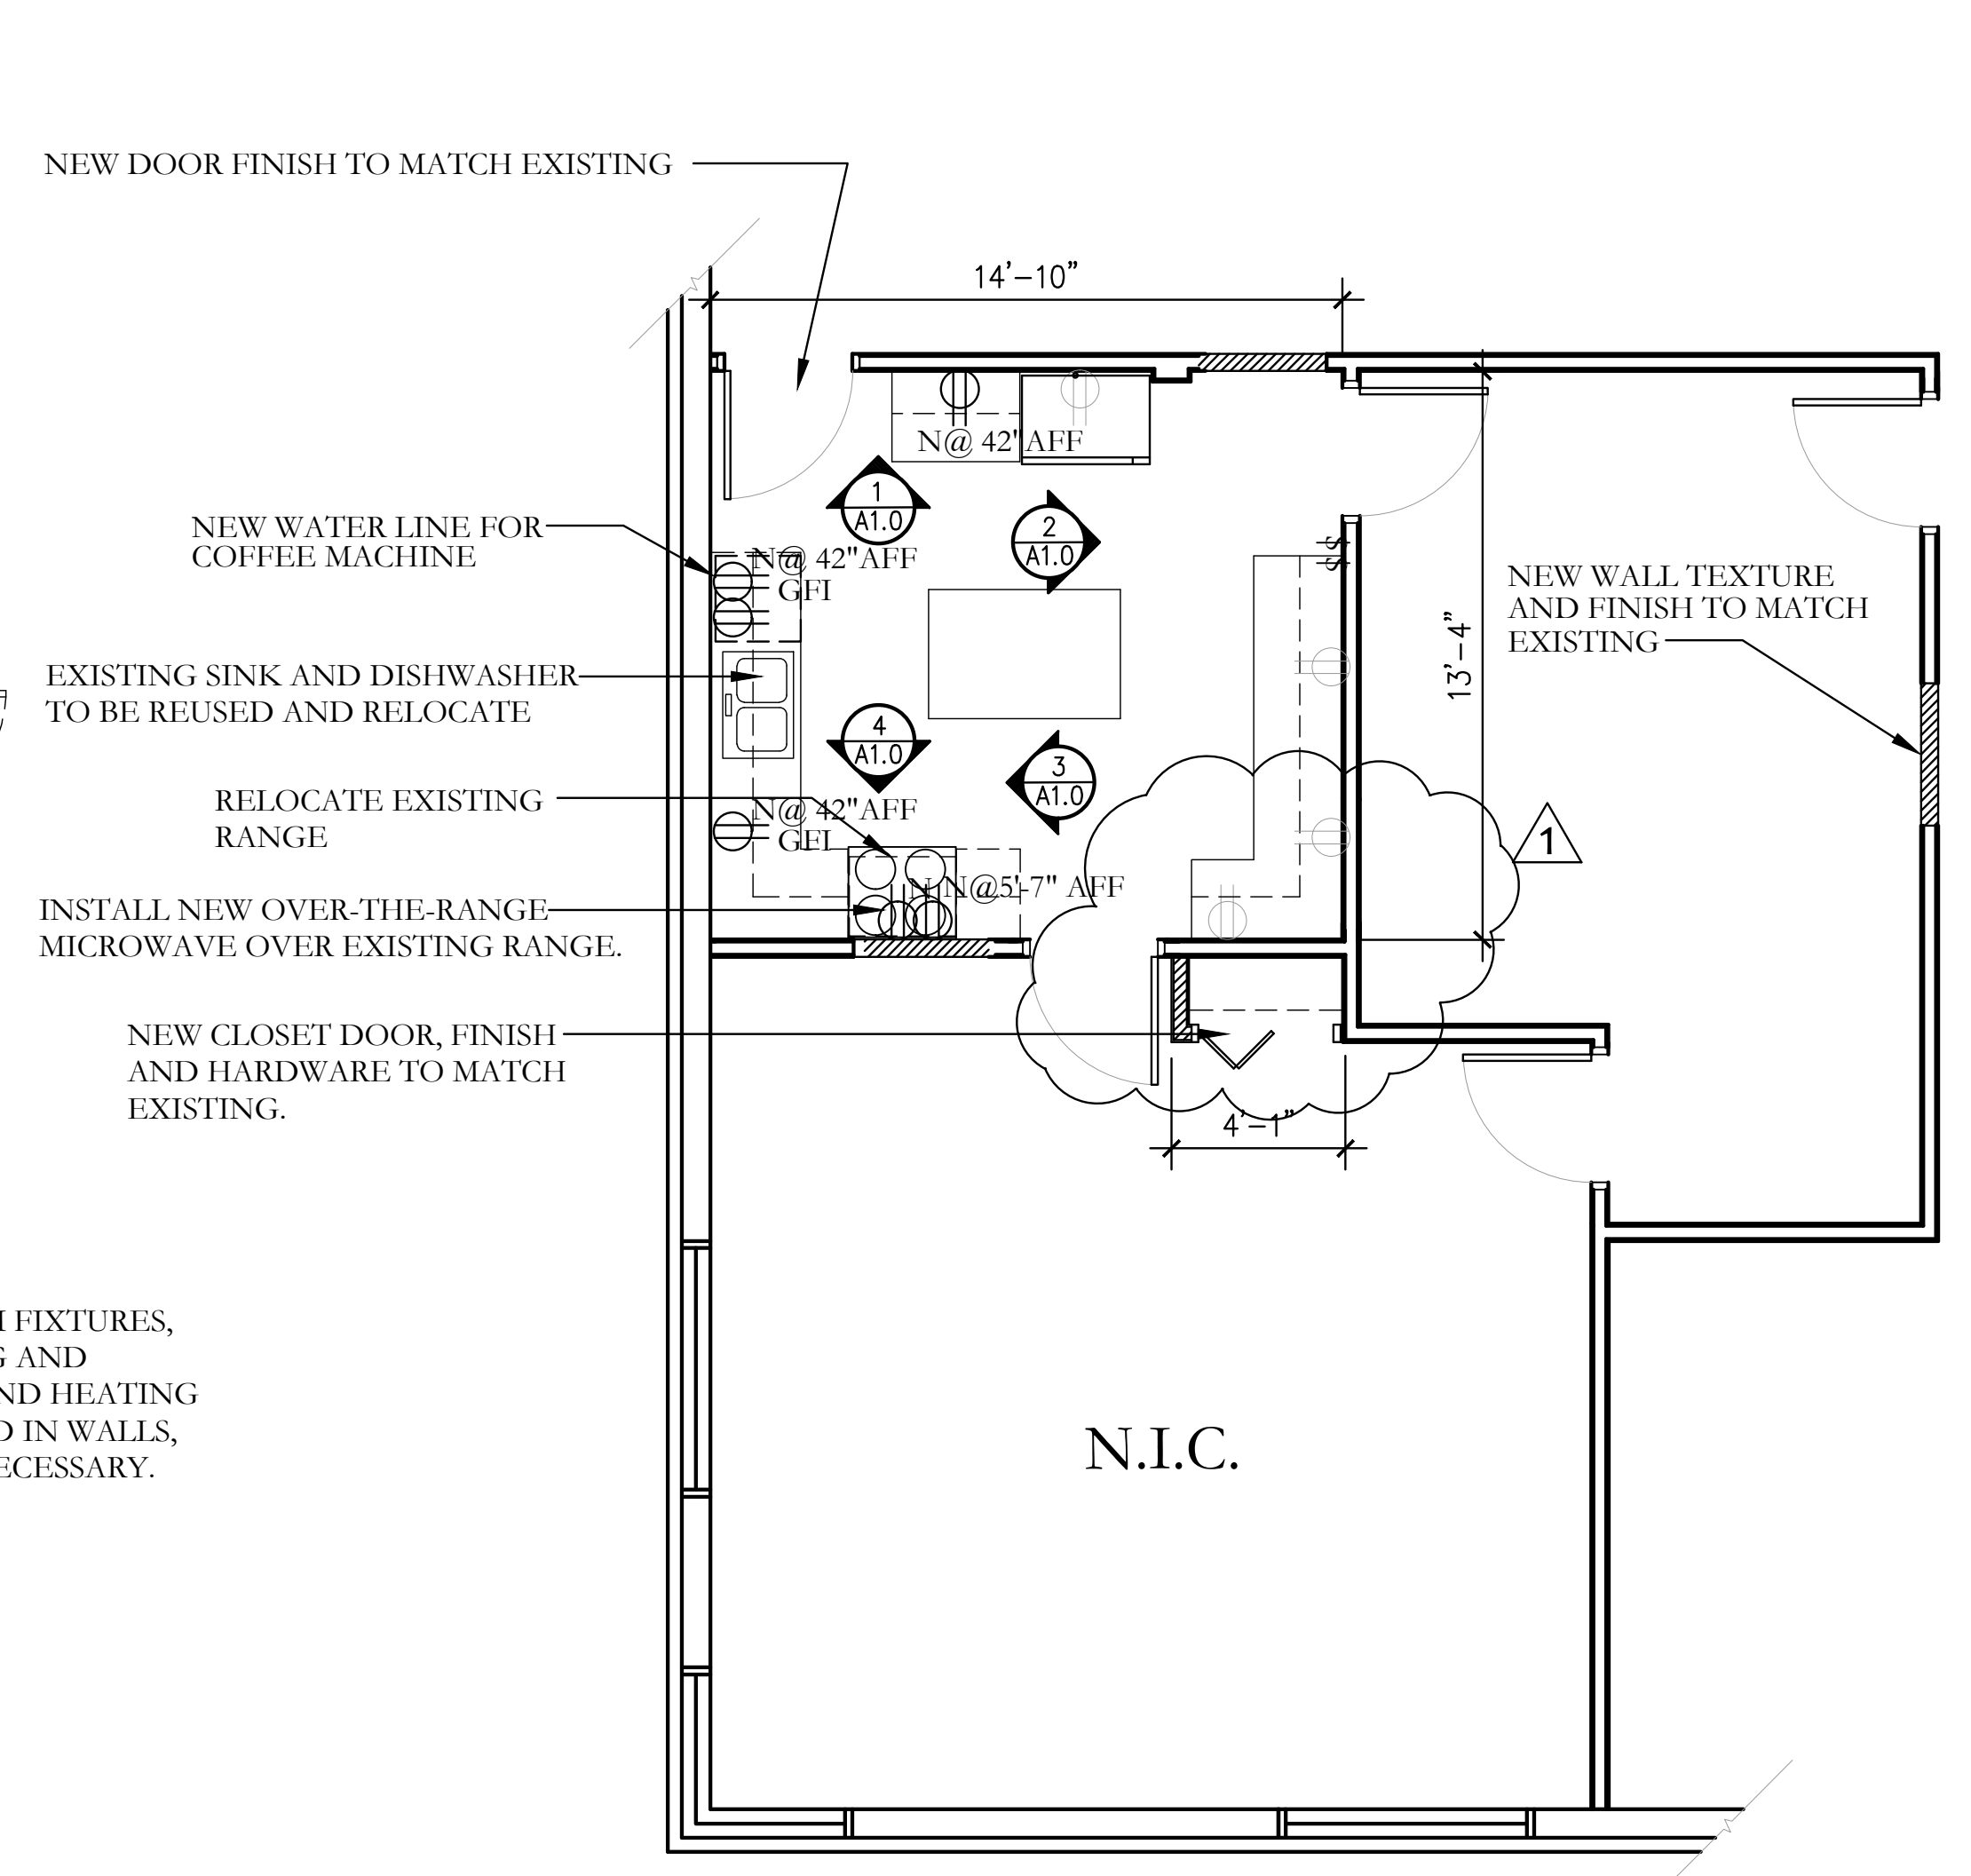


**EXECUTIVE KITCHEN REMODEL
PARTITION PLAN - NEW**


SCALE: 1/4" = 1'-0"

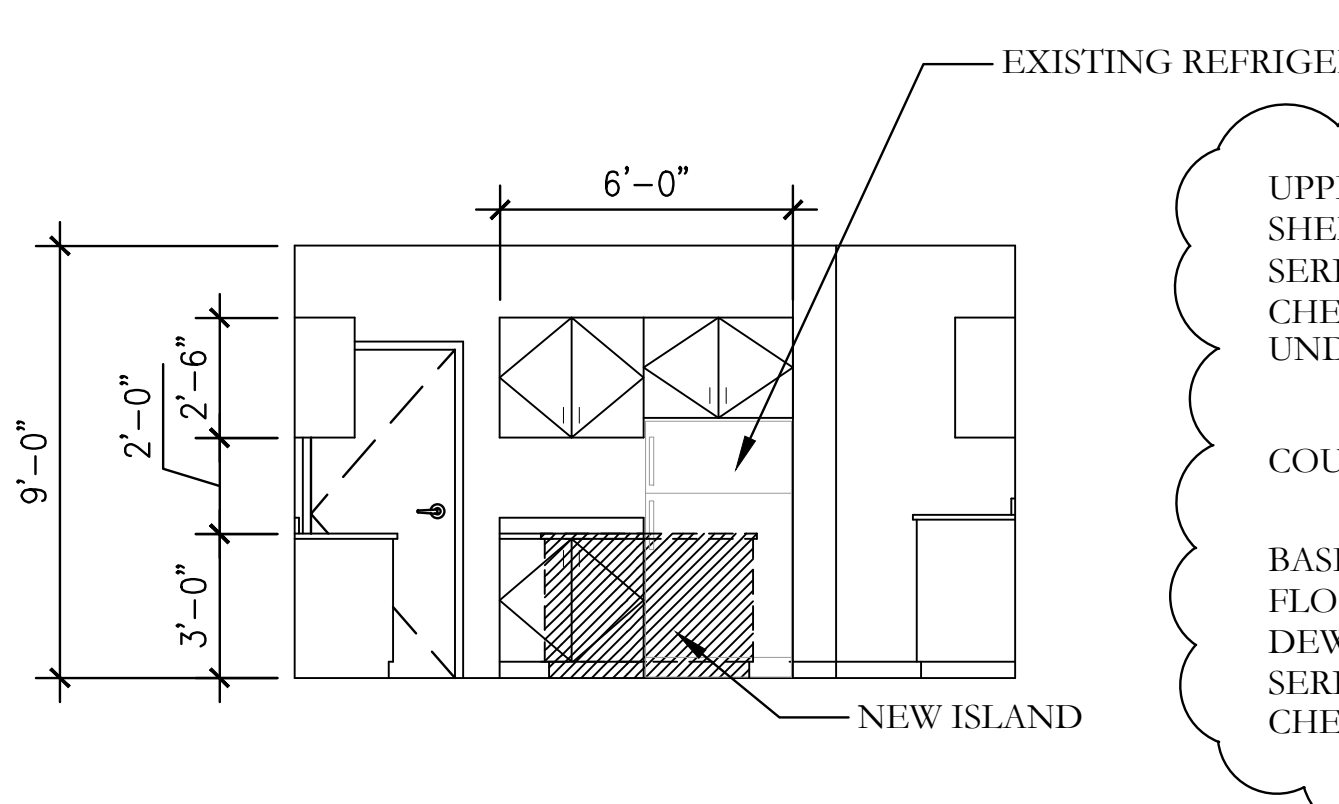


1 KITCHEN ELEVATION - SOUTH
A1.0 SCALE: 1/4" = 1'-0"

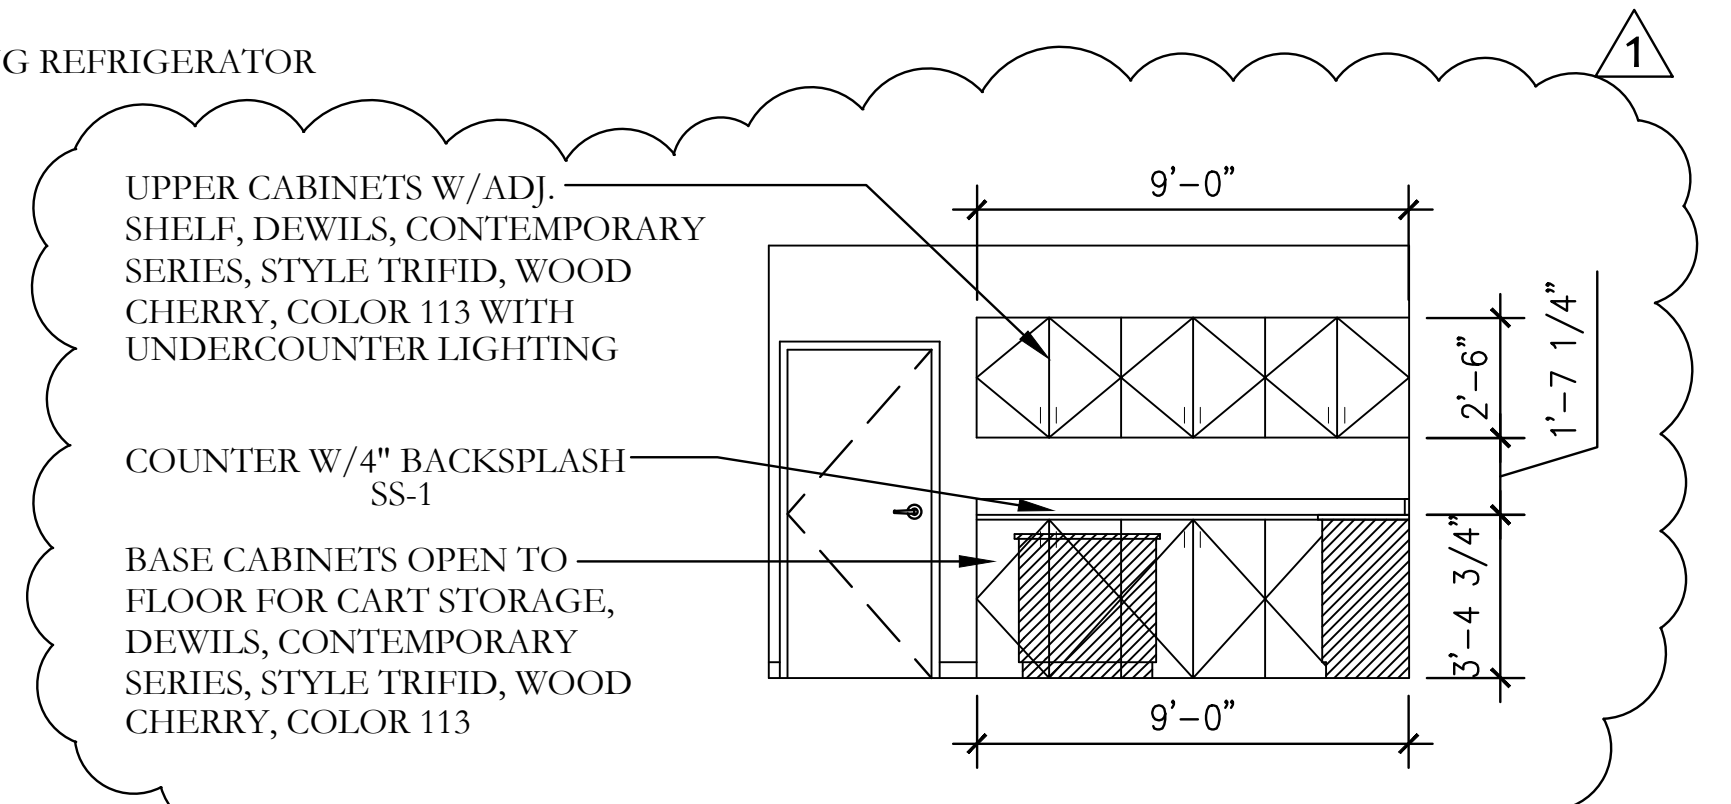


2 KITCHEN ELEVATION - WEST
A1.0 SCALE: 1/4" = 1'-0"

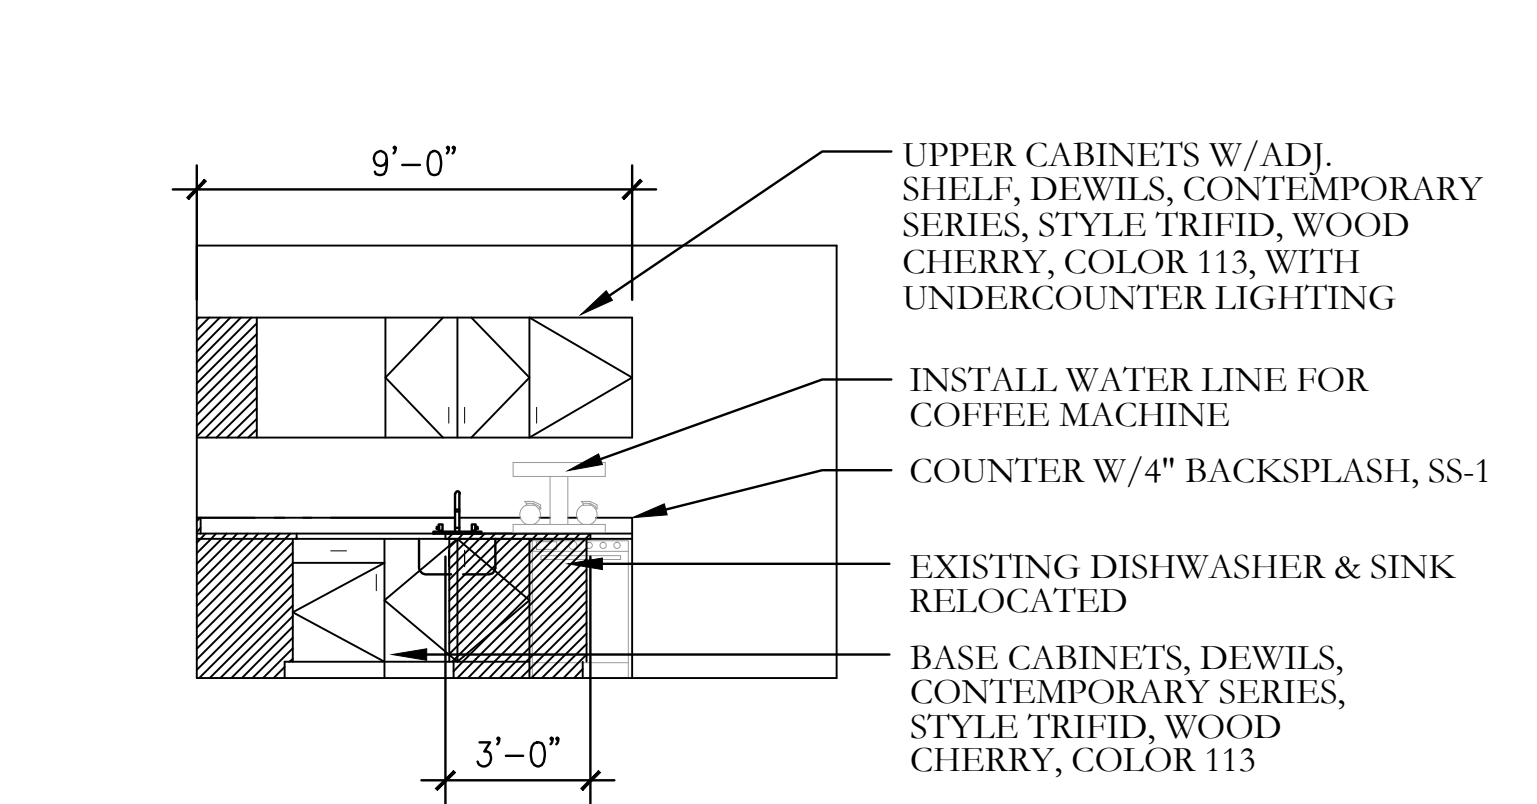

3 KITCHEN ELEVATION - EAST
A1.0 SCALE: 1/4" = 1'-0"

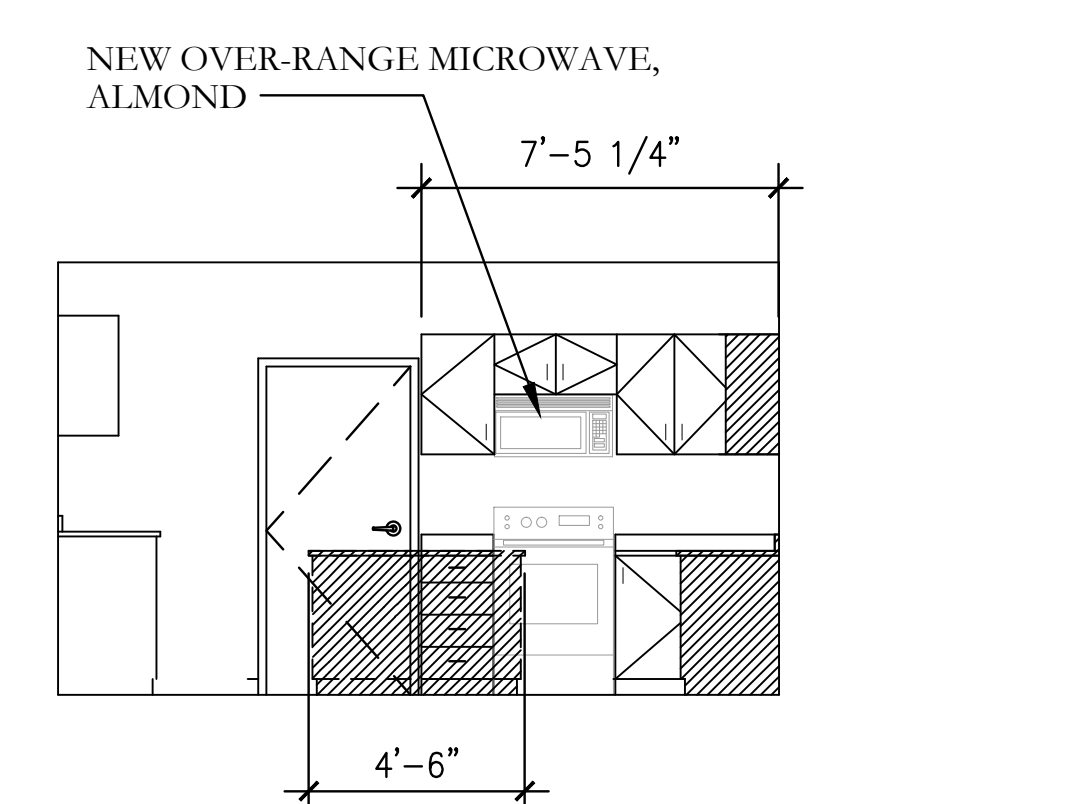

3 KITCHEN ELEVATION - NORTH
A1.0 SCALE: 1/4" = 1'-0"

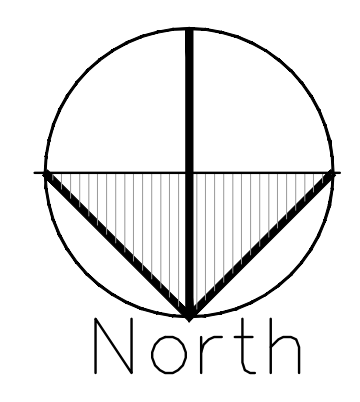

DRAWN BY: JLV
CHECKED: XXX
JOB NO: 09-015
DATE: 03FEB2010
SCALE: 1/4" = 1'-0"

REVISIONS:
1 3FEB2010

SHEET NO:
A1.0